

APPENDIX B2

WORKCOVER SEARCH



WorkCover NSW
92-100 Donnison Street, Gosford, NSW 2250
Locked Bag 2906, Lisarow, NSW 2252
T 02 4321 5000 F 02 4325 4145
WorkCover Assistance Service 13 10 50
DX 731 Sydney workcover.nsw.gov.au

Our Ref: D11/147542
Your Ref: Frances Kuipers

22 November 2011

RECEIVED
23 NOV 2011

BY:

Attention: Frances Kuipers
Geotechnique Pty Ltd
PO Box 880
Penrith NSW 2751

Dear Ms Kuipers,

RE SITE: Marsden Park Precinct

I refer to your site search request received by WorkCover NSW on 18 November 2011 requesting information on licences to keep dangerous goods for the above site.

Enclosed are copies of the documents that WorkCover NSW holds on Dangerous Goods Licence 35/031992, 35/032603, 35/014030, 35/008633, 35/032866, 35/023801, 35/024275, 35/025028 relating to the storage of dangerous goods at the above-mentioned premises, as listed on the Stored Chemical Information Database (SCID).

If you have any further queries please contact the Dangerous Goods Licensing Team on (02) 4321 5500.

Yours Sincerely

Brent Jones
Senior Licensing Officer
Dangerous Goods Notification Team

Application for Licence to Keep Dangerous Goods



Application for new licence amendment transfer renewal of expired licence

Expiry 28/3/98

PART A - Applicant and site information

 See page 2 of Guidance Notes.

1 Name of applicant ACN
Wayne Bieren P/L 003 862 842

2 Postal address of applicant Suburb/Town Postcode
306 South St MARSDEN PARK 2765

3 Trading name or site occupier's name
Bieren P/L

4 Contact for licence inquiries
Phone Fax Name
9628 3626 9628 3626 Wayne Palmer

5 Previous licence number (if known) 35/ 023801

6 Previous occupier (if known) Joe Dalba

7 Site to be licensed
No Street his issued 8/2/97 M
306 SOUTH ST MARSDEN PARK
Suburb / Town Postcode
MARSDEN PARK 2765

8 Main business of site CHICKEN FARM

9 Site staffing: Hours per day 24 Days per week 7

10 Site emergency contact
Phone Name
9628 3626 WAYNE PALMER

11 Major supplier of dangerous goods B KLEEN HEAT

12 If a new site or for amendments to depots - see page 4 of Guidance Notes.
Plan stamped by: Name of Accredited Consultant Date stamped
DAVID MUIR 6/11/97

I certify that the details in this application (including any accompanying computer disk) are correct and cover all licensable quantities of dangerous goods kept on the premises.

13 Signature of applicant Printed name Date
Wayne Palmer WAYNE PALMER 5/11/97


Please send your application, marked CONFIDENTIAL, to:
Dangerous Goods Licensing, Level 3, Locked Bag 10, Clarence Street, SYDNEY NSW 2000

RECEIVED
11/11/97
2055506

35-023801

Site Sketch

Please carefully read the instructions on page 3 of the Guidance Notes before sketching the site.

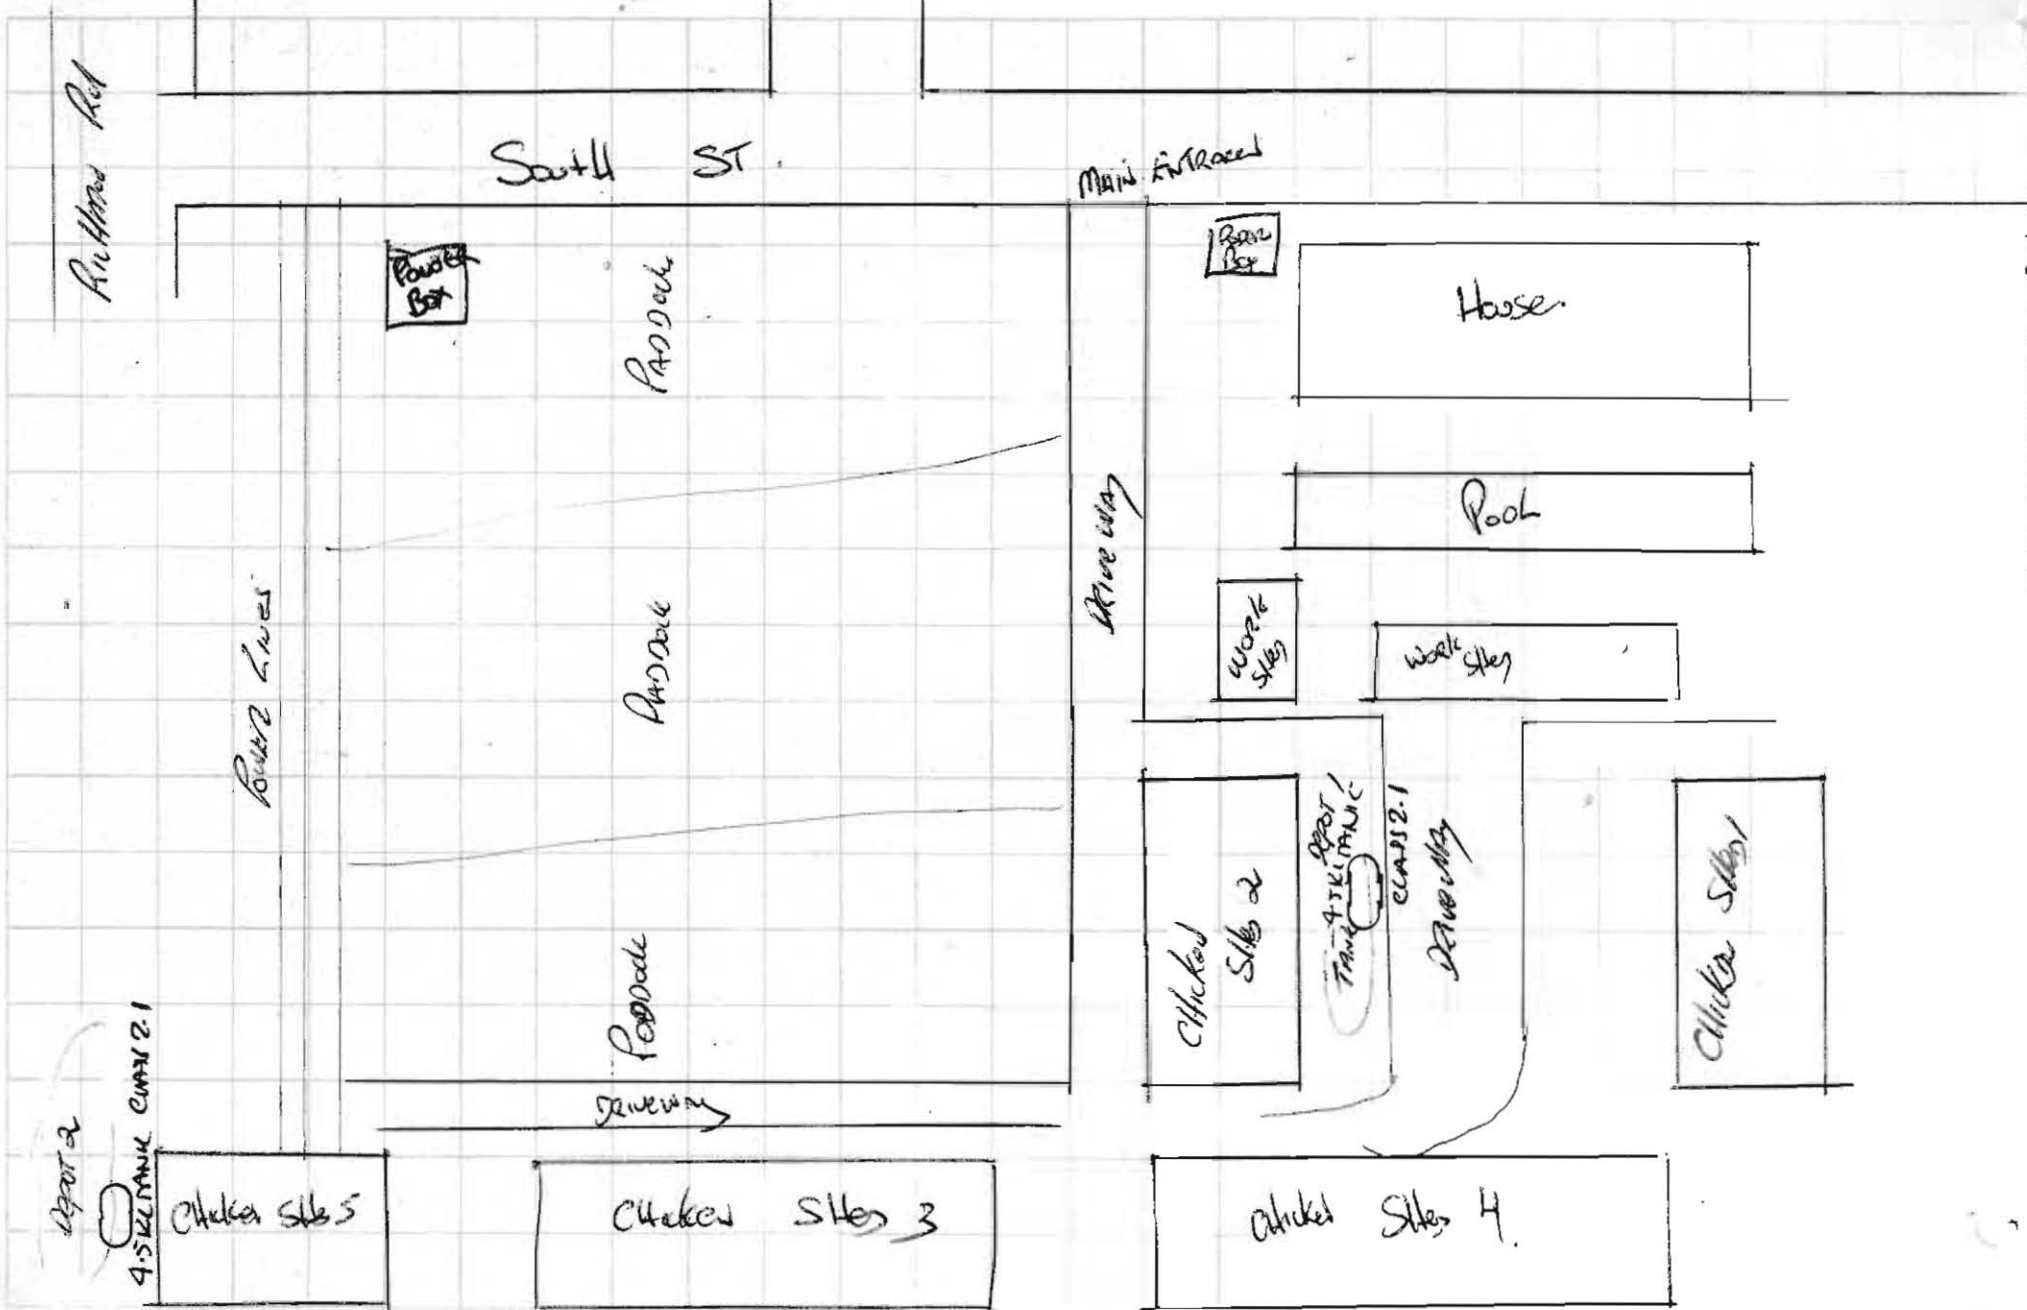

What is a depot? See page 5 of the Guidance Notes.

35-02380/

Part C - Dangerous Goods Storage Complete one section per depot.

If you have more depots than the space provided, photocopy sufficient sheets first.

Depot Number	Type of depot (see page 5)	Depot Class	Maximum storage capacity
1	ABOVE GROUND TANK	2-1	4500 L

UN Number	Proper Shipping Name	PG Class (I, II, III)	Product or common name	Typical quantity	Unit, e.g. L, kg, m ³
1075	PETROLEUM LIQUEFIED GAS	2.1 -	L.P.GAS	4500	L

Depot Number	Type of depot (see page 5)	Depot Class	Maximum storage capacity
2	ABOVE GROUND TANK	2-1	4500 L


UN Number	Proper Shipping Name	PG Class (I, II, III)	Product or common name	Typical quantity	Unit, e.g. L, kg, m ³
1075	PETROLEUM LIQUEFIED GAS	2.1 -	L.P.GAS	4500	L

Depot Number	Type of depot (see page 5)	Depot Class	Maximum storage capacity

UN Number	Proper Shipping Name	PG Class (I, II, III)	Product or common name	Typical quantity	Unit, e.g. L, kg, m ³

Depot Number	Type of depot (see page 5)	Depot Class	Maximum storage capacity

UN Number	Proper Shipping Name	PG Class (I, II, III)	Product or common name	Typical quantity	Unit, e.g. L, kg, m ³

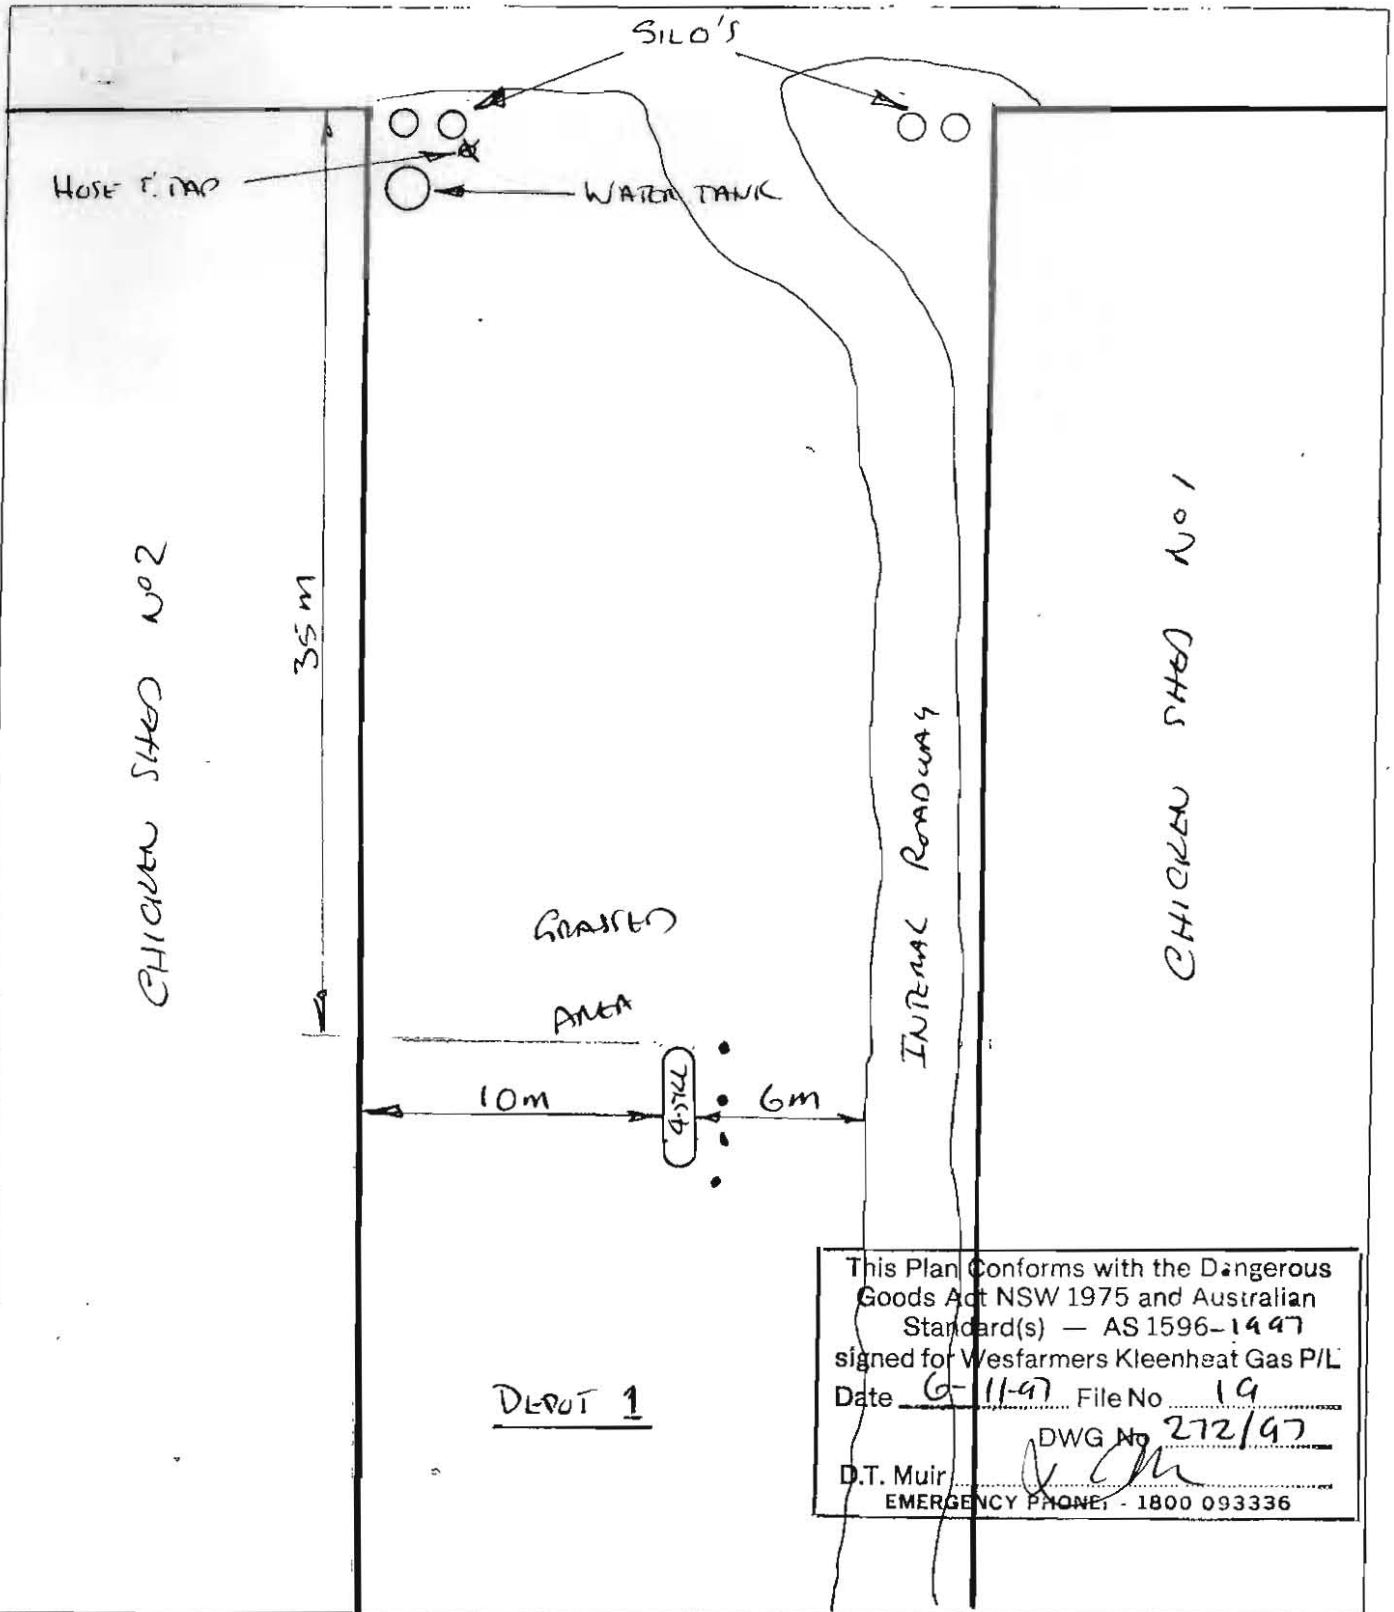


This Plan Conforms with the Dangerous Goods Act NSW 1975 and Australian Standard(s) — AS 1596-1997 signed for Wesfarmers Kleenheat Gas P/L
 Date 6-11-97 File No 19
 DWG No 272/97
 D.T. Muir *[Signature]*
 EMERGENCY PHONE - 1800 093336



NEW SOUTH WALES
 Suite 202, 30 Cowper Street, Parramatta NSW 2150
 Postal Address:
 PO Box W35, Parramatta NSW 2150
 Phone (02) 9633 7777 Fax (02) 9806 0218

CUSTOMER BIRDEN Pty Ltd 306 South Street Marsden Park	DATE 6-11-97	SCALE 1:250	REVISION
	CONTACT WAYNE PALMER	REP. DAVID MUIR	SHEET SIZE A4
	TANK SIZE 1x45KL	APPLICATION HEATING.	

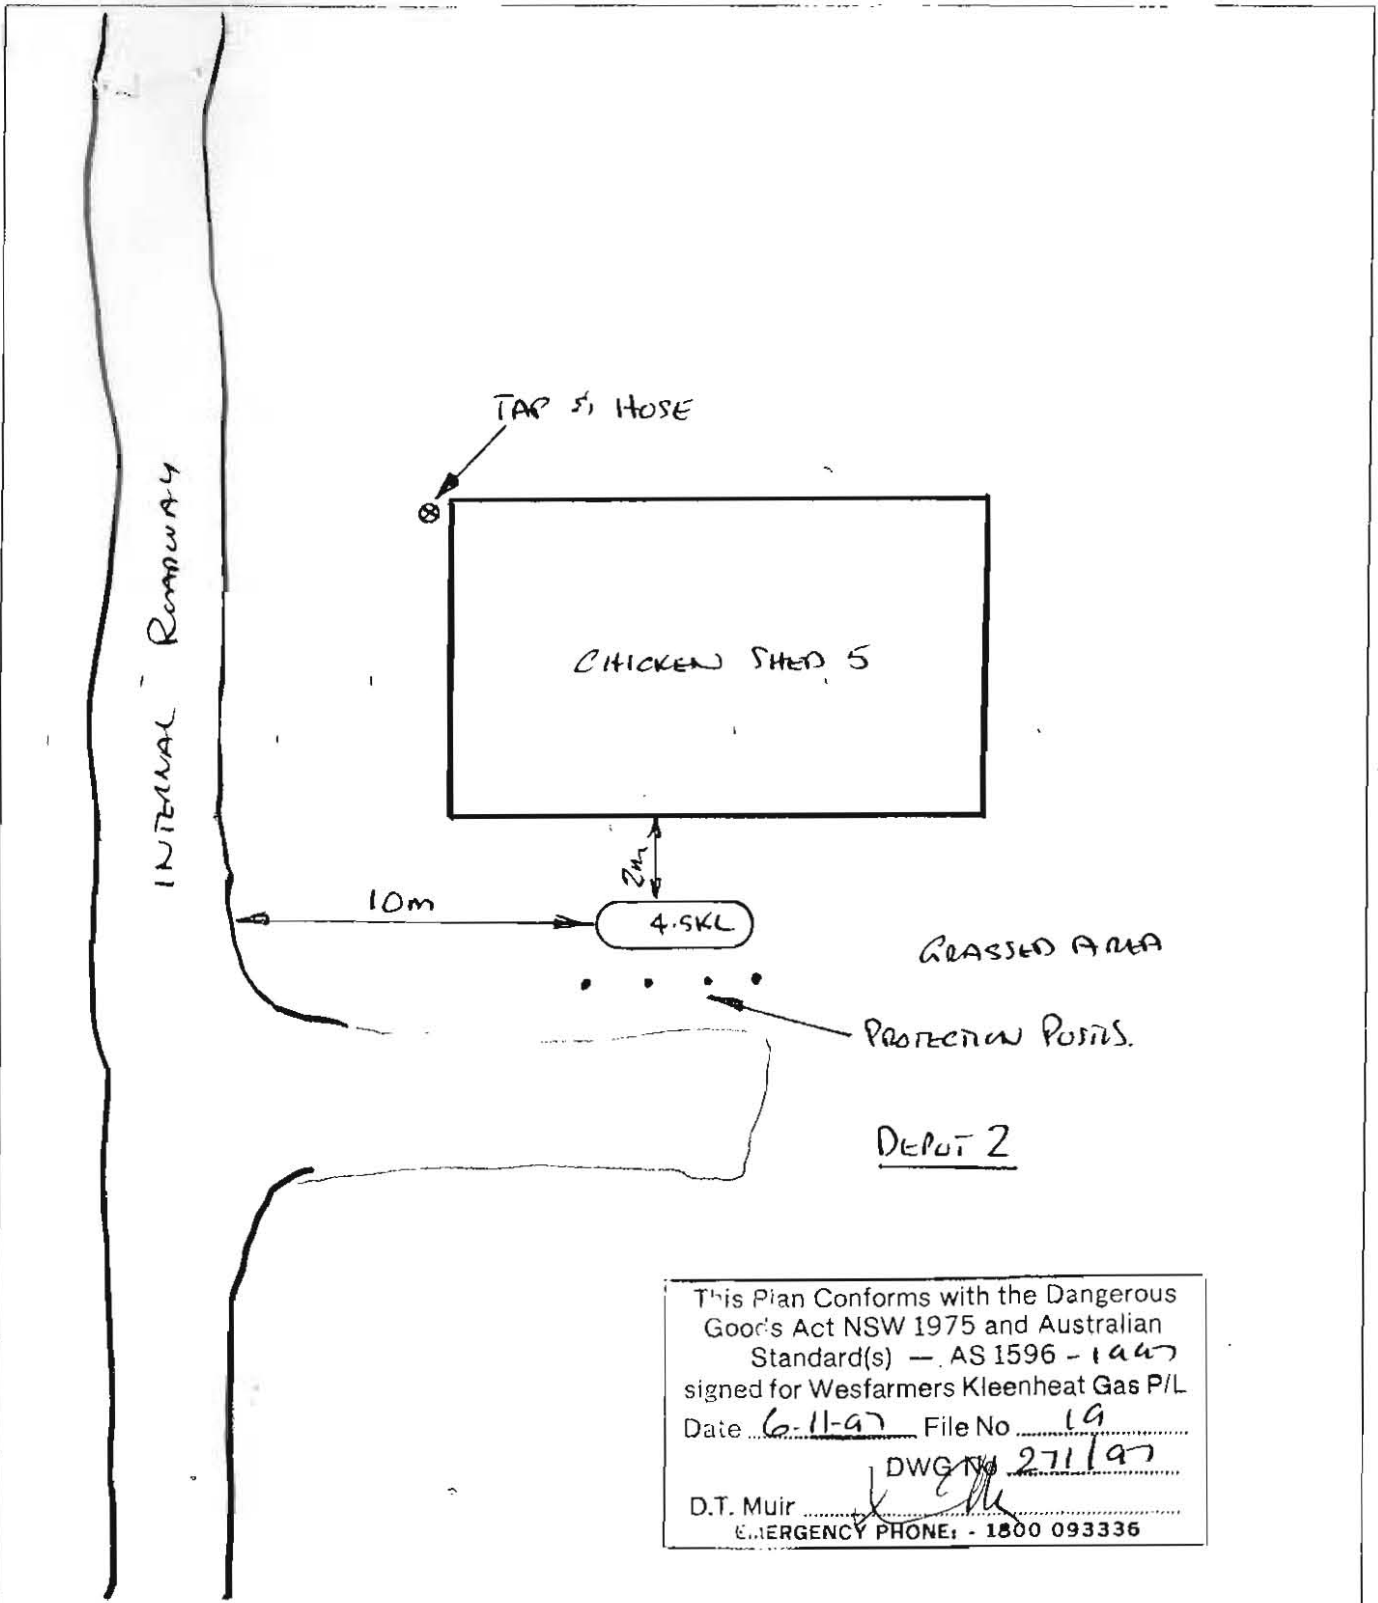

This Plan Conforms with the Dangerous Goods Act NSW 1975 and Australian Standard(s) — AS 1596 - 1997 signed for Wesfarmers Kleenheat Gas P/L Date 6-11-97 File No 19 DWG No 271197
 D.T. Muir *[Signature]*
 EMERGENCY PHONE: - 1800 093336

Kleenheat Gas
 Wesfarmers Kleenheat Gas Pty Ltd (Inc. in W.A.)
 A.C.N. 008 679 543

NEW SOUTH WALES
 Suite 202, 30 Cowper Street, Parramatta NSW 2130
 Postal Address:
 PO Box W35, PARRAMATTA NSW 2130
 Phone (02) 9633 7777 Fax (02) 9606 0218

CUSTOMER BIRDERN P/LTD 306 SOUTH STREET MARSDEN PARK	DATE 6-11-97	SCALE 1:200	REVISION
	CONTACT WAYNE PALMER	REP. DAVID MUIR	SHEET SIZE A4
	TANK SIZE 1x 4.5KL.	APPLICATION HEATING.	



DX 13067, MARKET ST, SYDNEY

Reference

APPLICATION FOR RENEWAL OF LICENCE TO KEEP DANGEROUS GOODS

ISSUED UNDER AND SUBJECT TO THE PROVISIONS OF THE DANGEROUS GOODS ACT, 1975 AND REGULATION THEREUNDER

RECEIVED
MAIL ROOM
24 FEB 1997
NEW SOUTH WALES

DECLARATION: Please renew licence number 35/023801 to 1998. I confirm that all the licence details shown below are correct (amend if necessary).


 (Signature)
 for: SALIBA J & V

 J & V SALIBA
 (Please print name)

 20.2.97
 (Date signed)

THIS SIGNED DECLARATION SHOULD BE RETURNED TO:

WorkCover New South Wales
 Dangerous Goods Licensing Section (Level 3)
 Locked Bag 10
 P O CLARENCE STREET 2000

Enquiries: ph (02) 9370 5187
 fax (02) 9370 6105

Details of licence on 5 February 1997

Licence Number 35/023801 Expiry Date 28/03/97
 Licensee SALIBA J & V

Postal Address 306 SOUTH ST, MARSDEN PARK 2765
 Licensee Contact JOE OR VICKY Ph. 628 3626
 Premises Licensed to Keep Dangerous Goods
 306 SOUTH ST LOT 6
 MARSDEN PARK 2765

Nature of Site Poultry Farming (Meat) Major Supplier of Dangerous Goods ~~ELGAS~~ *KILNHEAT*
 Emergency Contact for this Site A Cauchi (AH 628 4935) ph. 628 3626
 Site staffing 24 HRS 7 DAYS

Details of Depots

Depot No.	Depot Type	Goods Stored in Depot	Qty
1	ABOVE-GROUND TANK	Class 2.1 UN 1075 PETROLEUM GASES, LIQUE	5000 L 2500 L
2	ABOVE-GROUND TANK	Class 2.1 UN 1075 PETROLEUM GASES, LIQUE	5000 L 2500 L

DATA
 26 FEB 1997
ENTERED
 24 FEB 1997

PART A
SCIENTIFIC SERVICES
BRANCH
28 MAY 1993
DANGEROUS
GOODS



WORKCOVER AUTHORITY

LICENCE TO KEEP DANGEROUS GOODS

(Dangerous Goods Act 1975)

Expiry: 28.3.96

Application for new licence, amendment or transfer

VS TO application 052 1.7.92

1. Name of applicant ISSUE LICENCE AS PER DGI ACN

JOE & VICKY SALIBA

2. Site to be licensed Lot 6

No 306 Street SOUTH ST

Suburb/Town MARSDEN PARK Postcode 2765

3. Previous licence number (if known) 35/023801

4. Nature of site FARMING 0124

5. Emergency contact on site:

Phone 628 3626 Name OR. RA. CAUCHI 628 4935

6. Site staffing: Hours per day Full time 24 Days per week 7

7. Major supplier of dangerous goods ELBAS LTD / CENTRAL CHEMICAL INDUSTRIES

8. If new site or significant modification
Plan stamped by: _____ Accredited consultant's name: _____ Date stamped: _____

9. Number of dangerous goods depots at site 2 LPG TANKS (BULK)

10. Trading name or occupier's name J. V. SALIBA delete (F3)

11. Postal address of applicant Suburb/Town Postcode

306 SOUTH ST MARSDEN PARK 2765

12. Contact for licence enquiries:

Phone 628 3626 Fax _____ Name JOE OR VICKY

I certify that the details contained in this application (or the accompanying computer disk) are true and correct


13. Signature of applicant [Signature] Date 21.5.93

35/023801

Site Sketch

Please carefully read the instructions in Part B of the guide before sketching the site.

PART B

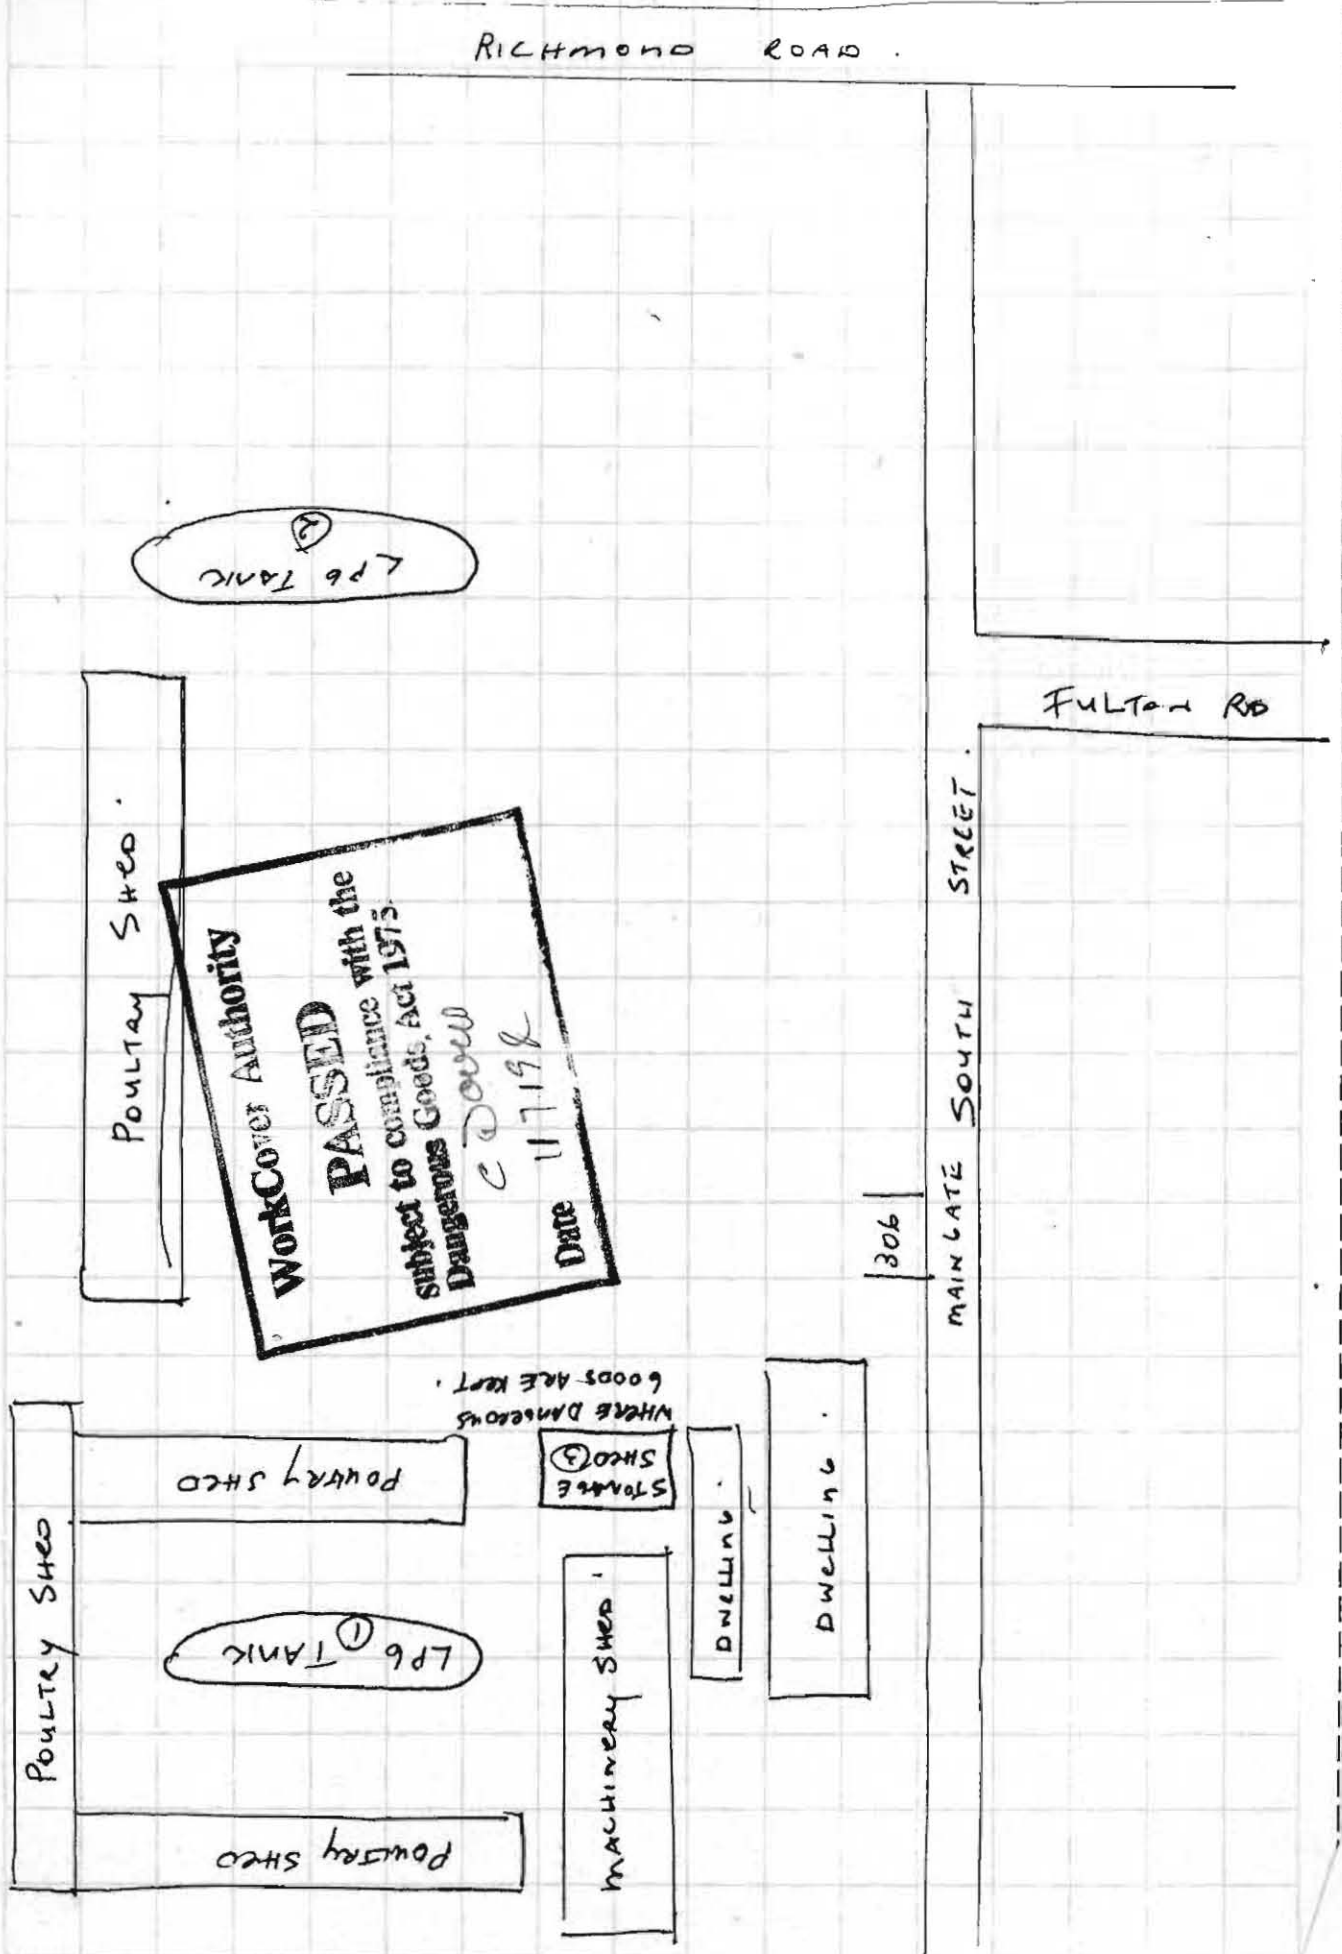

RICHMOND ROAD

FULTON RD

MAIN GATE SOUTH STREET

306

POULTRY SHED

POULTRY SHED

POULTRY SHED

LP6 TANK ①

POULTRY SHED

MACHINERY SHED

STORAGE SHED ②

WHERE DANGEROUS GOODS ARE KEPT

DWELLING

DWELLING

LP6 TANK ②

WorkCover Authority
PASSED
subject to compliance with the
Dangerous Goods Act 1973
C. Dowell
Date 11/7/98

If you have more depots than the space provided, photocopy sufficient sheets first.

Depot number	Type of depot	Class			Licensed maximum storage capacity	
①	LPG				Autobank 5000 L	
UN number	Shipping name	Pkg. Class Group EPG		Product or common name	Typical quantity	Uniteg. L, kg, m ³
1075	Petroleum Gas	2.1	2A2	LPGas	2500	L

Depot number	Type of depot	Class			Licensed maximum storage capacity	
②	LPG				Autobank 5000 L	
UN number	Shipping name	Pkg. Class Group EPG		Product or common name	Typical quantity	Uniteg. L, kg, m ³
1075	Petroleum Gas	2.1	2A2	LPGas	2500	L

Depot number	Type of depot	Class			Licensed maximum storage capacity	
③	IMMEDIATELY DANGEROUS					
UN number	Shipping name	Pkg. Class Group EPG		Product or common name	Typical quantity	Uniteg. L, kg, m ³

Depot number	Type of depot	Class			Licensed maximum storage capacity	
UN number	Shipping name	Pkg. Class Group EPG		Product or common name	Typical quantity	Uniteg. L, kg, m ³

FOR THE KEEPING OF DANGEROUS GOODS

Application is hereby made for—
described below.

*a licence (or amendment of the licence)
*the transfer of the licence

for the keeping of dangerous goods in or on the premises

FEE: \$10.00 per Depot for new licence.
\$10.00 for amendment or transfer.

(*delete whichever is not required)

Name of Applicant in full (see over)	JOE & VICKY SALIBA		5846 27/08/84	03A
Trading name or occupier's name (if any)	AS ABOVE TF / SUNSET FARM			
Postal address	SUNSET FARM 15 BOOBY HILL RD PLUMPTON		Postcode	2761
Address of the premises including street number (if any)	LOT 6 SOUTH ST SUNSET FARM MARSBURN PARK		Postcode	
Nature of premises (see over)	POULTRY FARMING			
Telephone number of applicant	STD Code	02	Number	625 0067

Particulars of type of depots and maximum quantities of dangerous goods to be kept at any one time.

Depot number	Type of depot (see over)	Storage capacity	Dangerous goods	C & C Office use only
			Product being stored	
1	ABOVEGROUND TANK	3000	PROPANE	DD 002 100 0 1 100 33
2	/	4200	/	1 100 43
3				
4				
5				
6				
7				
8				
9				
10				
11				
12				



Has site plan been approved? Yes No If yes, no plans required. If no, please attach site plan.

Have premises previously been licensed? Yes No If yes, state name of previous occupier. ABOVE

Name of company supplying flammable liquid (if any) PORTA-GAS

Signature of applicant *[Signature]* Date 10.8.84

For external explosives magazine(s), please fill in side 2.

FOR OFFICE USE ONLY **CERTIFICATE OF INSPECTION**
I, RAYMOND CHARLES MCRASH being an Inspector under the Dangerous Goods Act, 1975, do hereby certify that the premises described above do comply with the requirements of the Dangerous Goods Act, 1975, and the Dangerous Goods Regulation with regard to their situation and construction for the keeping of dangerous goods of the nature and in the quantity specified.
Signature of Inspector *[Signature]* Date 15.8.84

Licence No.

OPERATOR ONE

FOR THE KEEPING OF DANGEROUS GOODS

Mar 89

Application is hereby made for— ~~a licence (or amendment of the licence)~~ for the keeping of dangerous goods in or on the premises
~~the transfer of the licence~~

FEE: \$10.00 per Depot for new licence.
 \$10.00 for amendment or transfer.

(*delete whichever is not required)

Name of Applicant in full (see over)	J & V SALIBA #3107		
Trading name or occupier's name (if any)			
Postal address	15 ROOBY HILL RD	PLUMPTON	Postcode 2761
Address of the premises including street number (if any)	LOT 6	"SOUTH ST" MARSDEN PARK	Postcode 2765
Nature of premises (see over)	POULTRY FARMS		
Telephone number of applicant	STD Code	Number	

Particulars of type of depots and maximum quantities of dangerous goods to be kept at any one time.

Depot number	Type of depot (see over)	Storage capacity	Dangerous goods	C & C Office use only
			Product being stored	
1	ABOVEGROUND TANK	3000 L	PROPANE 21	DD001 100.0 1 100 33
2				
3				
4				
5				
6				
7				
8				
9				
10				
11				
12	file P/A			

4B



Has site plan been approved? Yes No If yes, no plans required. If no, please attach site plan.

Have premises previously been licensed? Yes No If yes, state name of previous occupier.

Name of company supplying flammable liquid (if any) PORTA-GAS

Signature of applicant *[Signature]* Date 6.3.84

For external explosives magazine(s), please fill in side 2.

FOR OFFICE USE ONLY CERTIFICATE OF INSPECTION

I, RAYMOND CHARLES MCGRAH being an Inspector under the Dangerous Goods Act, 1975, do hereby certify that the premises described above do comply with the requirements of the Dangerous Goods Act, 1975, and the Dangerous Goods Regulation with regard to their situation and construction for the keeping of dangerous goods of the nature and in the quantity specified.

Signature of Inspector *[Signature]* Date 22.5.84

Licence No.



BOUNDARY * OPEN SPACE

1806mm

12500mm

POULTRY SHED.

91400mm

1ST STAGE

1066mm

4.2 KL.

TANK.

1066mm

FUTURE POULTRY SHED.

* NEAREST Public Place within 100m is
AT LINES SOUTH ST.

Lot 6



PROPOSED 4.2 KL L.P.G. GAS TANK FOR
J & V. SALIBA.
LOT 6 SOUTH ST. MARSDEN PARK.

Postal Address & RESIDENCE 15 Rooth Hill Rd PLUMPTON. 625-0067.



29 BRAYS ROAD, CONCORD, 2137
Phone- 736 3855
THE GAS TO USE IF YOU'RE NOT ON THE GAS


CONTACT Bruce D. [unclear]

200 METRES + PROTECTIVE WORKS
FROM SOUTH ST.
(PUBLIC PLACE)

PROPOSED 3 KL. L.P.G. BULK GAS TANK
FOR J & V. SALIBA.
LOT 6 SOUTH ST.
MARSDEN PARK.


AGL PORTA-GAS
29 BRAYS ROAD, CONCORD, 2137
Phone: 736 3855
THE GAS TO USE IF YOU'RE NOT ON THE GAS

SHED 200 METRES
FROM ROADWAY.
BUILT ON OPEN LAND.

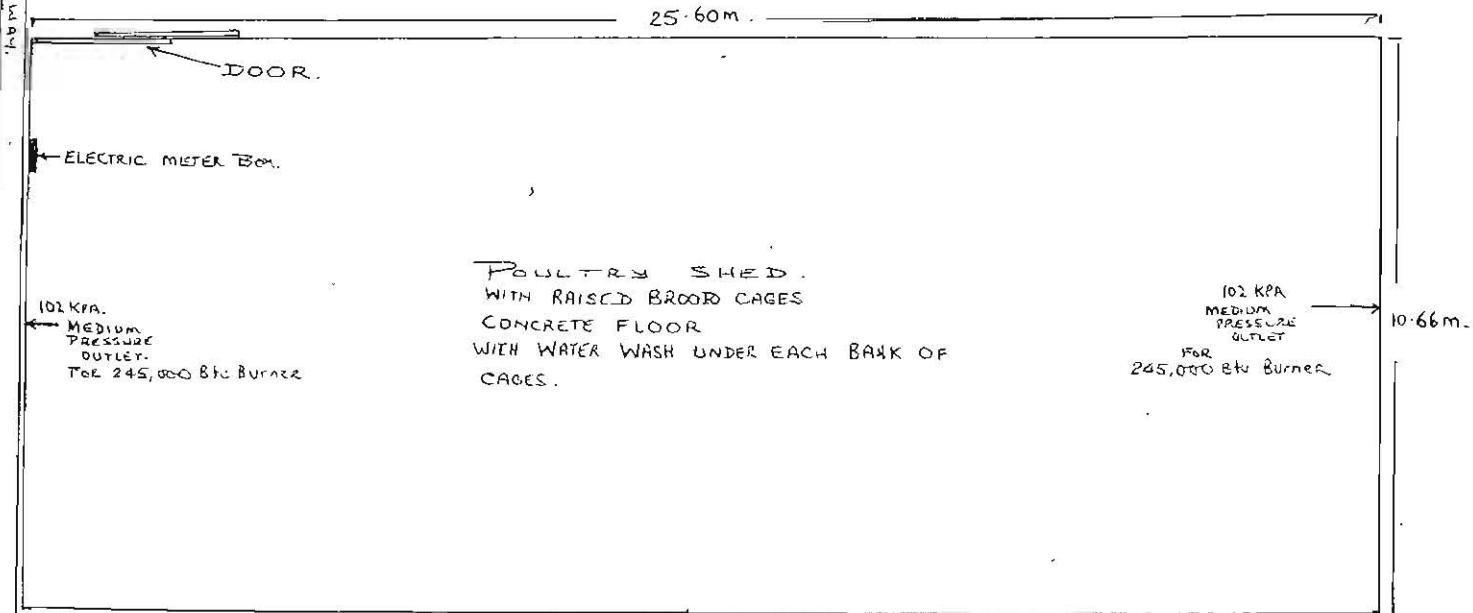

BULK FEED

OPEN SPACE

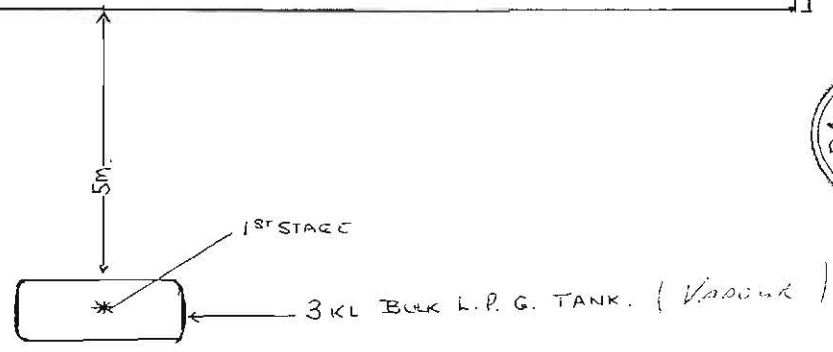

CONTACT FOR NOTIFICATION INQUIRIES

Title: Mr / Miss / Ms / Mrs / Other (please specify) MR Family name LEES
 Given name RICHARD Other names GRAHAM
 Gender Male Female (please circle) Date of birth 18 / 6 / 58 Place of birth SYDNEY
 Postal address PO BOX 6545
 Suburb BAULKHAM HILLS State NSW Postcode 2153
 Business phone 02 8883 1555 Business fax number 02 8883 1455
 Business email address richard@meteor-fwks.com.au

Previous licence number or acknowledgement number (if known)

35/

Previous occupier (if known)

Site on which dangerous goods are to be kept

Number 60 Street GLENGARRIE ROAD, MARSDEN PARK

Nearest cross street

SOUTH STREET

Lot and DP if no street number

LOT 3

Is the site staffed? If yes, state number of employees 1-2

Site staffing: Hours per day 1-2 Days per week 5

Site emergency contact

Phone number 0298994819 Name RICHARD LEES (AFTER HOURS NO.)

Nature of the site (eg farm, warehouse, shop etc)

FENCED RURAL property with 3 warehouses

Nature of your primary business activity

Storage and distribution of party goods

ABN (if any)

99 002744452

Website details (if any)

What is the ANSZIC code most applicable to you business? (see guide for list of codes and further information)

Code 479 Description OTHER WHOLESALING

Attach a site sketch of the premises. Refer to the Guide for information on the requirements for the site sketch.

Attach a photocopy page from a local street directory or other map showing the locality of the premises. Mark the location of the premises with an X

List the dangerous goods that will be stored and/or processed on these premises. Copy this page and attach additional sheets if there is insufficient space.

Identifier	Type of storage location or process	Class	Maximum storage capacity (L, kg, M ³)
1	Roofed Store	1.4	200,000 kg

UN Number	Proper shipping name	Class	PG (I, II, III)	Product or common name	HazChem symbol	Typical qty	Unit eg L, kg, M ³
0337	Toy Fireworks	1.4	III	SPARKLERS			Kg
0337	Toy Fireworks	1.4	III	PARTY POPPERS			

Identifier	Type of storage location or process	Class	Maximum storage capacity (L, kg, M ³)
2	Roofed Store	2	200,000 kg

UN Number	Proper shipping name	Class	PG (I, II, III)	Product or common name	HazChem symbol	Typical qty	Unit eg L, kg, M ³
1950	Aerosols	2.1	III	Wacky String		15,000	Kg
1950	Aerosols	2.2	III	Hair Spray - Coloured		15,000	Kg

Identifier	Type of storage location or process	Class	Maximum storage capacity (L, kg, M ³)
3	Roofed Store	1.4	200,000 kg

UN Number	Proper shipping name	Class	PG (I, II, III)	Product or common name	HazChem symbol	Typical qty	Unit eg L, kg, M ³
0337	Toy Fireworks	1.4	III	SPARKLERS		20,000	Kg
0337	Toy Fireworks	1.4	III	PARTY POPPERS		10,000	Kg

Identifier	Type of storage location or process	Class	Maximum storage capacity (L, kg, M ³)

UN Number	Proper shipping name	Class	PG (I, II, III)	Product or common name	HazChem symbol	Typical qty	Unit eg L, kg, M ³

Identifier	Type of storage location or process	Class	Maximum storage capacity (L, kg, M ³)

UN Number	Proper shipping name	Class	PG (I, II, III)	Product or common name	HazChem symbol	Typical qty	Unit eg L, kg, M ³

* SECURITY SENSITIVE DANGEROUS GOODS ONLY

GLENGARRIE ROAD

Turning Circle
- Dead end road.

Lot 3 NO. 60
GLENGARRIE RD
MARSDEN PARK

Fence

Gate

Fence

Fence

SEALED DRIVEWAY

Amenities

Gate


BARBED WIRE TOPPED
8' FENCE

Depot 1

Depot 2

Depot 3

Nearest Home
300m

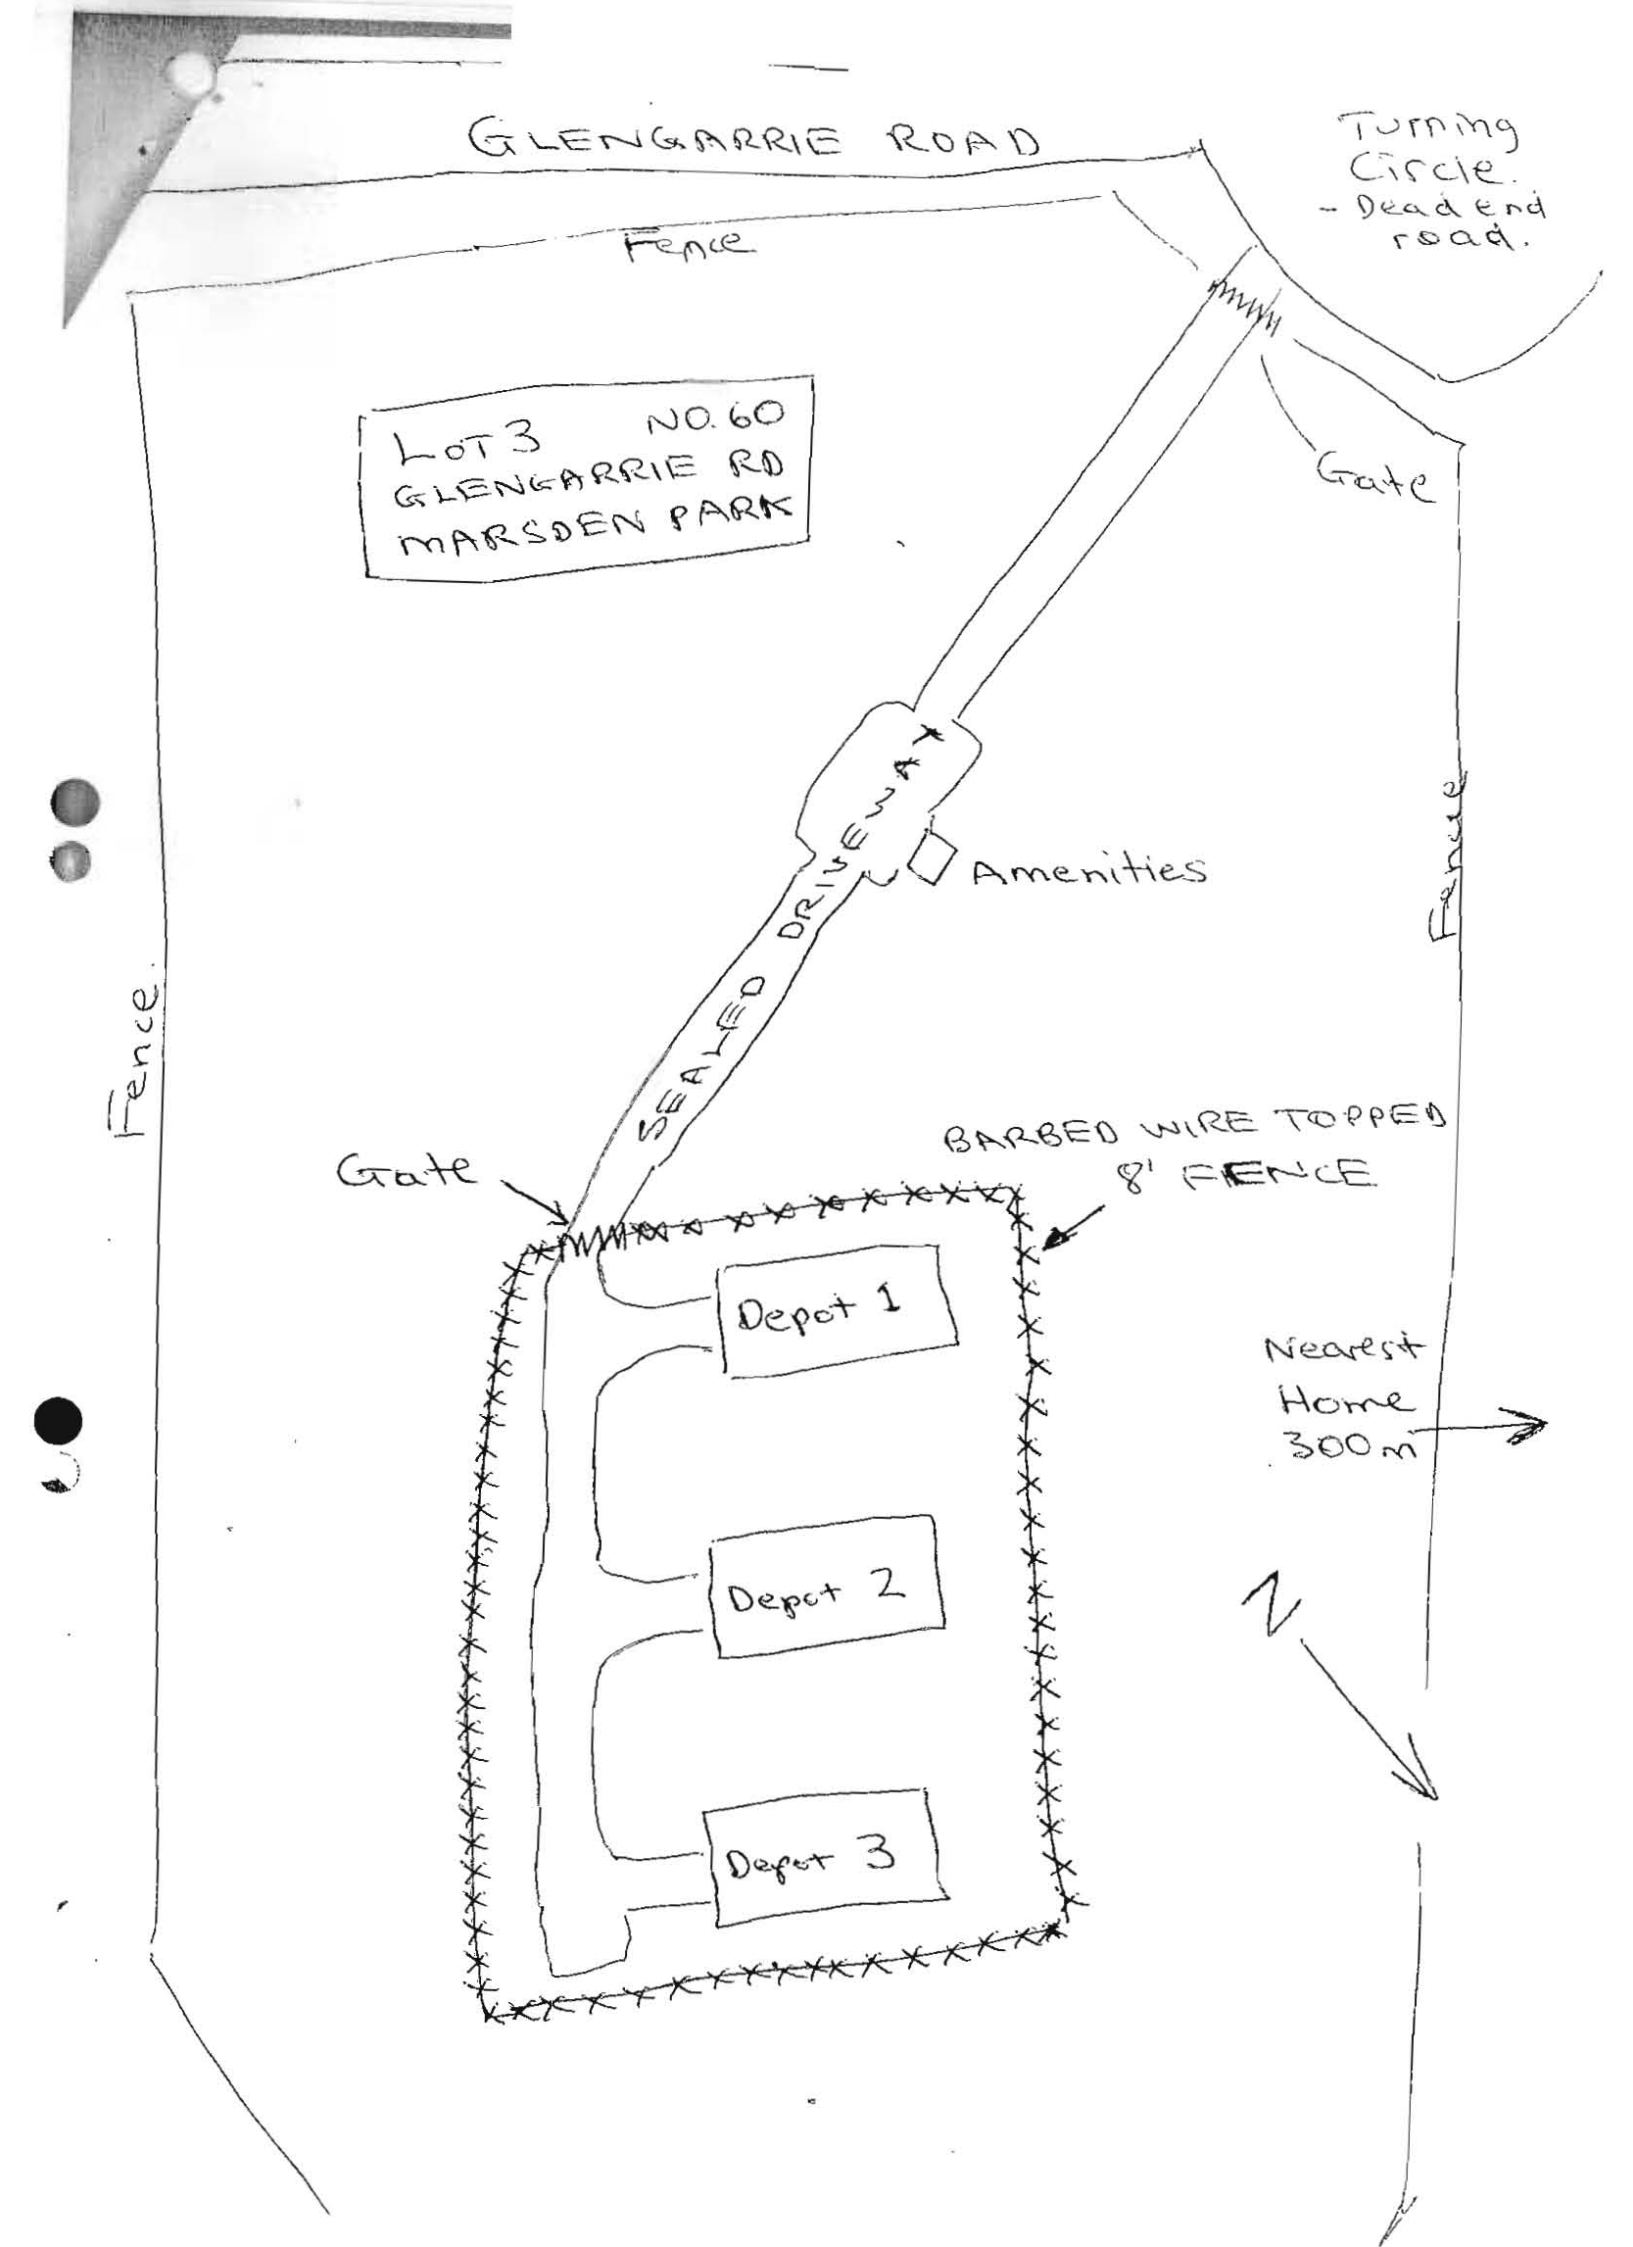

Meteor Fireworks Pty Ltd

PO. Box 603 Crows Nest NSW 2065 Australia
Telephone Office - (02) 649 5449, (02) 957 1259
Warehouse: (02) 628 3320
Telex BFIELD AA27171

11th November, 1985

Mr. H.N. Blackmore,
Chief Inspector,
Dangerous Goods Branch,
PO Box 847,
DARLINGHURST NSW 2010

Dear Sir,

We enclose, herewith, completed Application Forms for Licence to Import or Sell Explosives and Licence for the Keeping of Dangerous Goods. We also enclose our cheque number 586207 for \$30.00 covering Licence fees of \$15.00 for each application.

All information regarding our warehouse facility (except telephone numbers) is unchanged to that given by J.S. Imports Pty Ltd in gaining its Licence Numbers 43.009013.0 and 35.023020.8. However, please note that these Applications are for 'a licence', not an amendment to the ones held by J.S. Imports Pty Ltd.

At this stage, we require both companies to be Licenced for importation and storage until J.S. Imports finally ceases to trade in fireworks.

Looking forward to your comments.

Yours faithfully,
METEOR FIREWORKS PTY LTD



JOHN M. SIMMONS
DIRECTOR

JMS:sf
Enc...

File 35023020.8 was
cancelled Feb 88